



# **RED-LINED DRAWING SHEETS**

**consisting of Figs. 10b, 13, 14,  
19b, 23b, 24 and 26**

**TO INDICATE REVISIONS,  
OF U.S. PATENT APPLICATION  
09/903,059**

**ATTORNEY DOCKET NO.  
NS-4971 US**

**RECEIVED  
JAN 14 2003  
TECHNOLOGY CENTER 2800**

Fig.  
10a

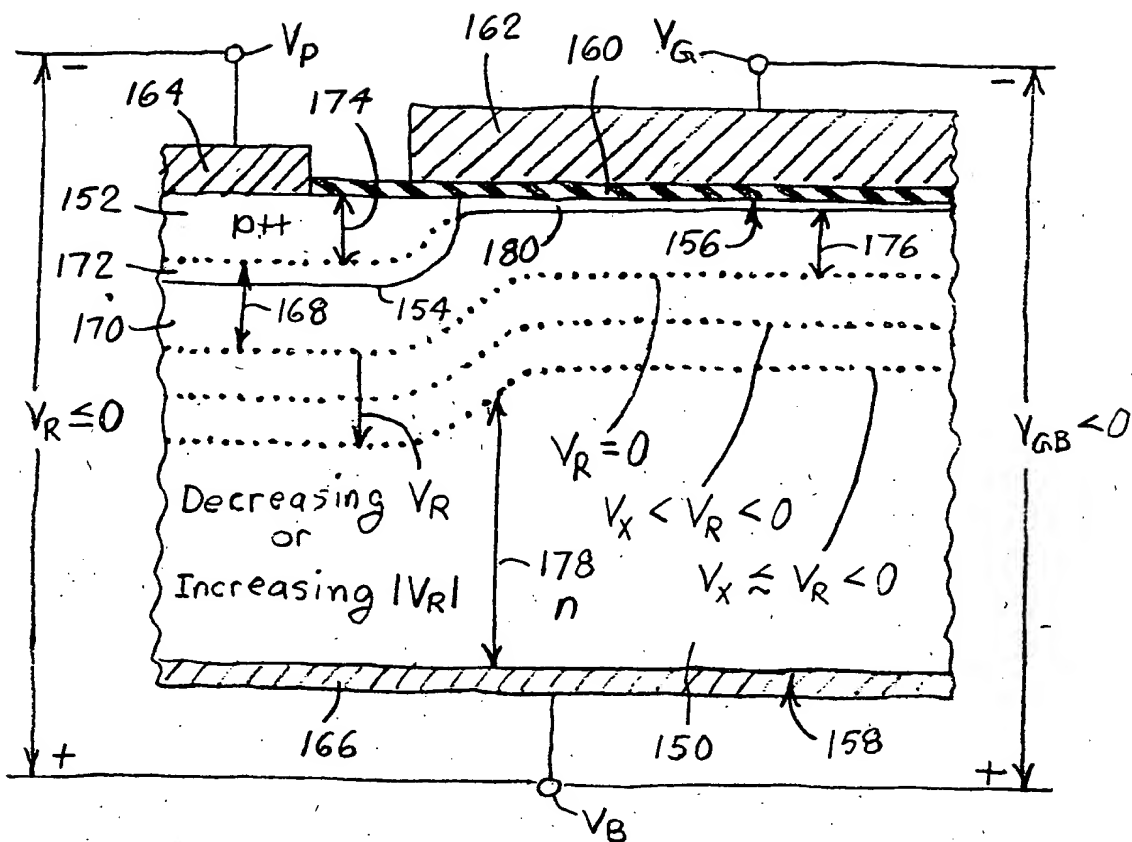
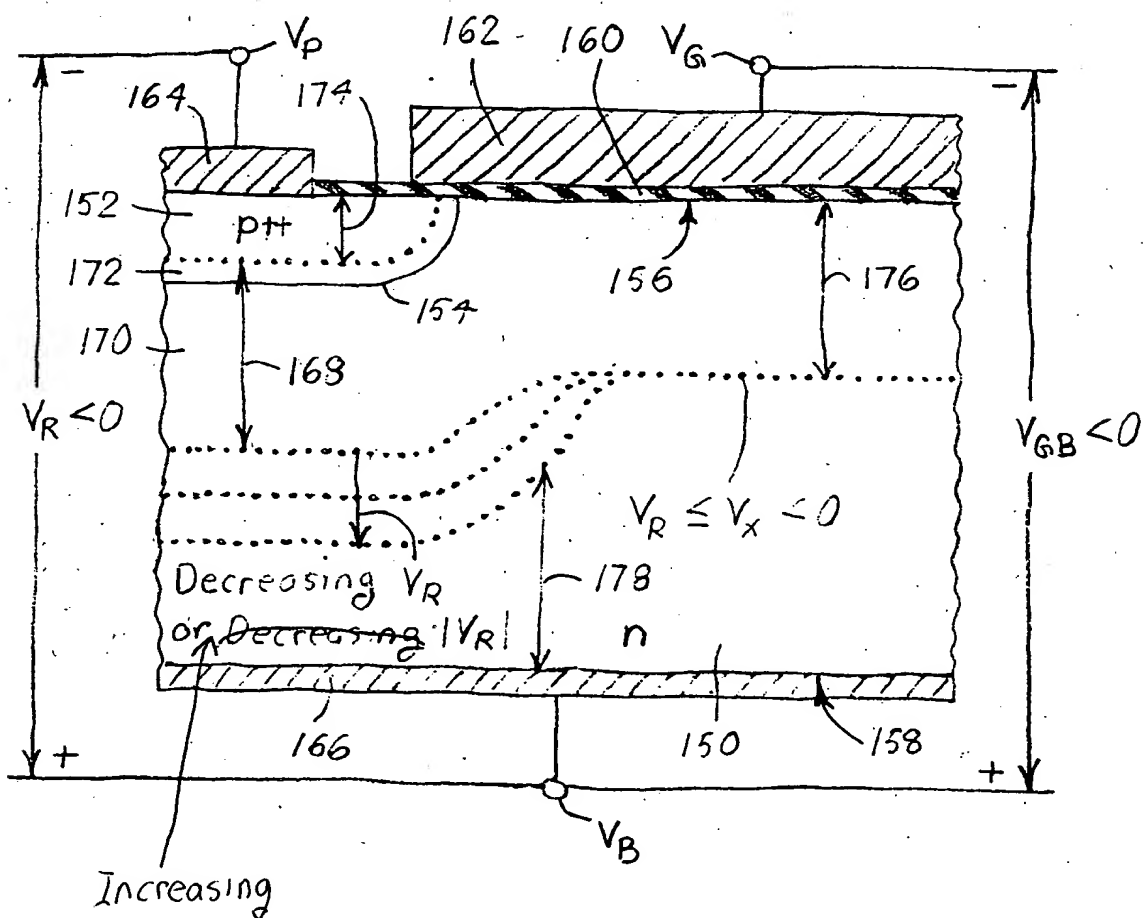


Fig.  
10b



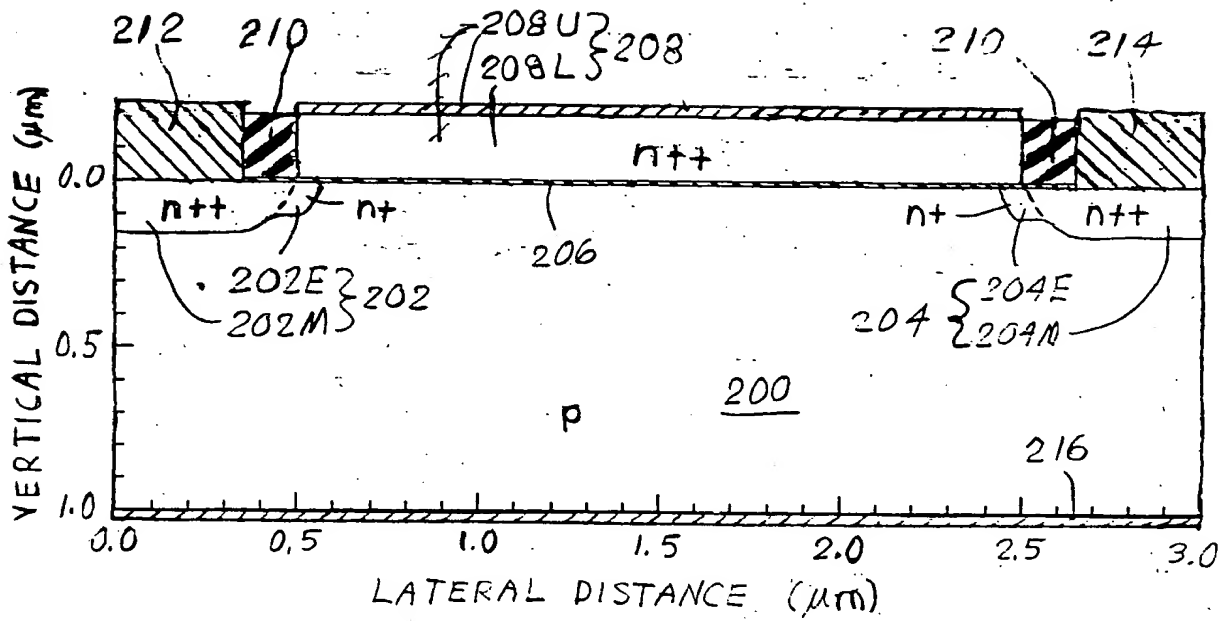


Fig. 13




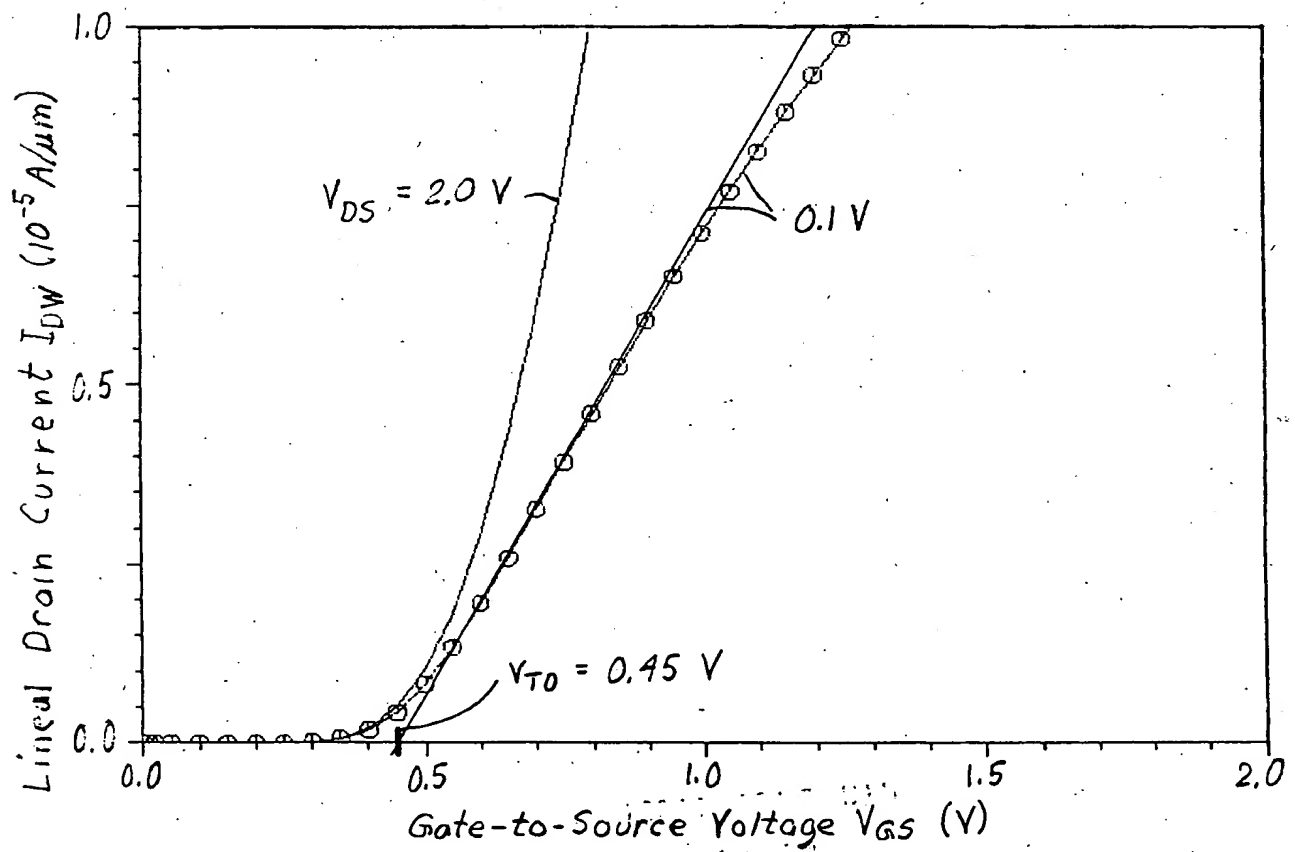


Fig. 14

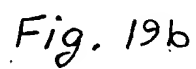

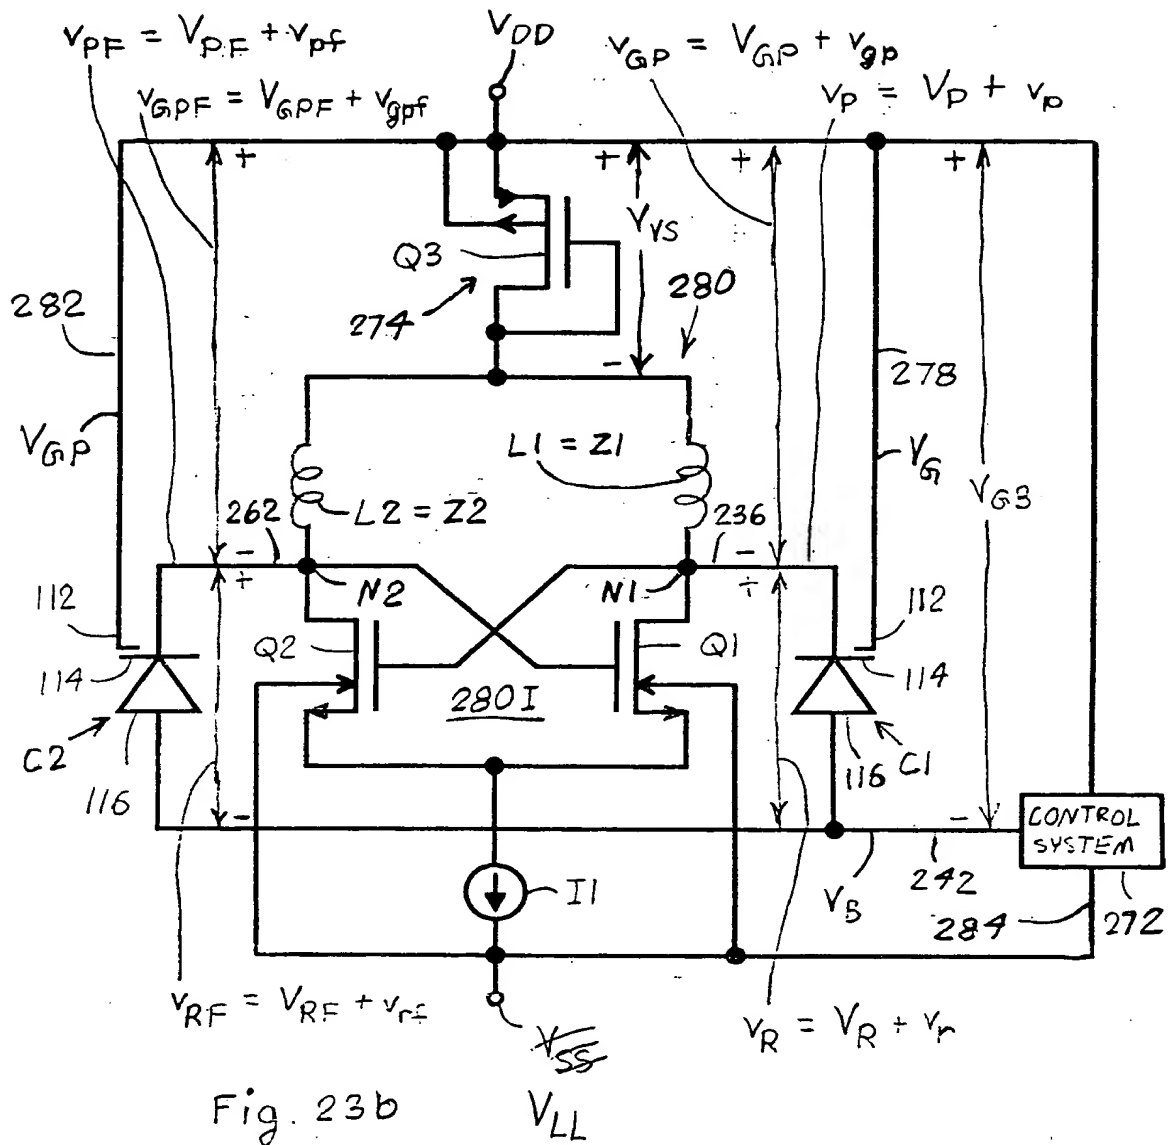

RECEIVED  
JAN 14 2003  
TECHNOLOGY CENTER 2800

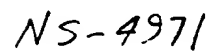

RECEIVED  
JAN 14 2003  
TECHNOLOGY CENTER 2800

